NORTHERN TRADING ASSOC., INC. 250 6-71 #3799+

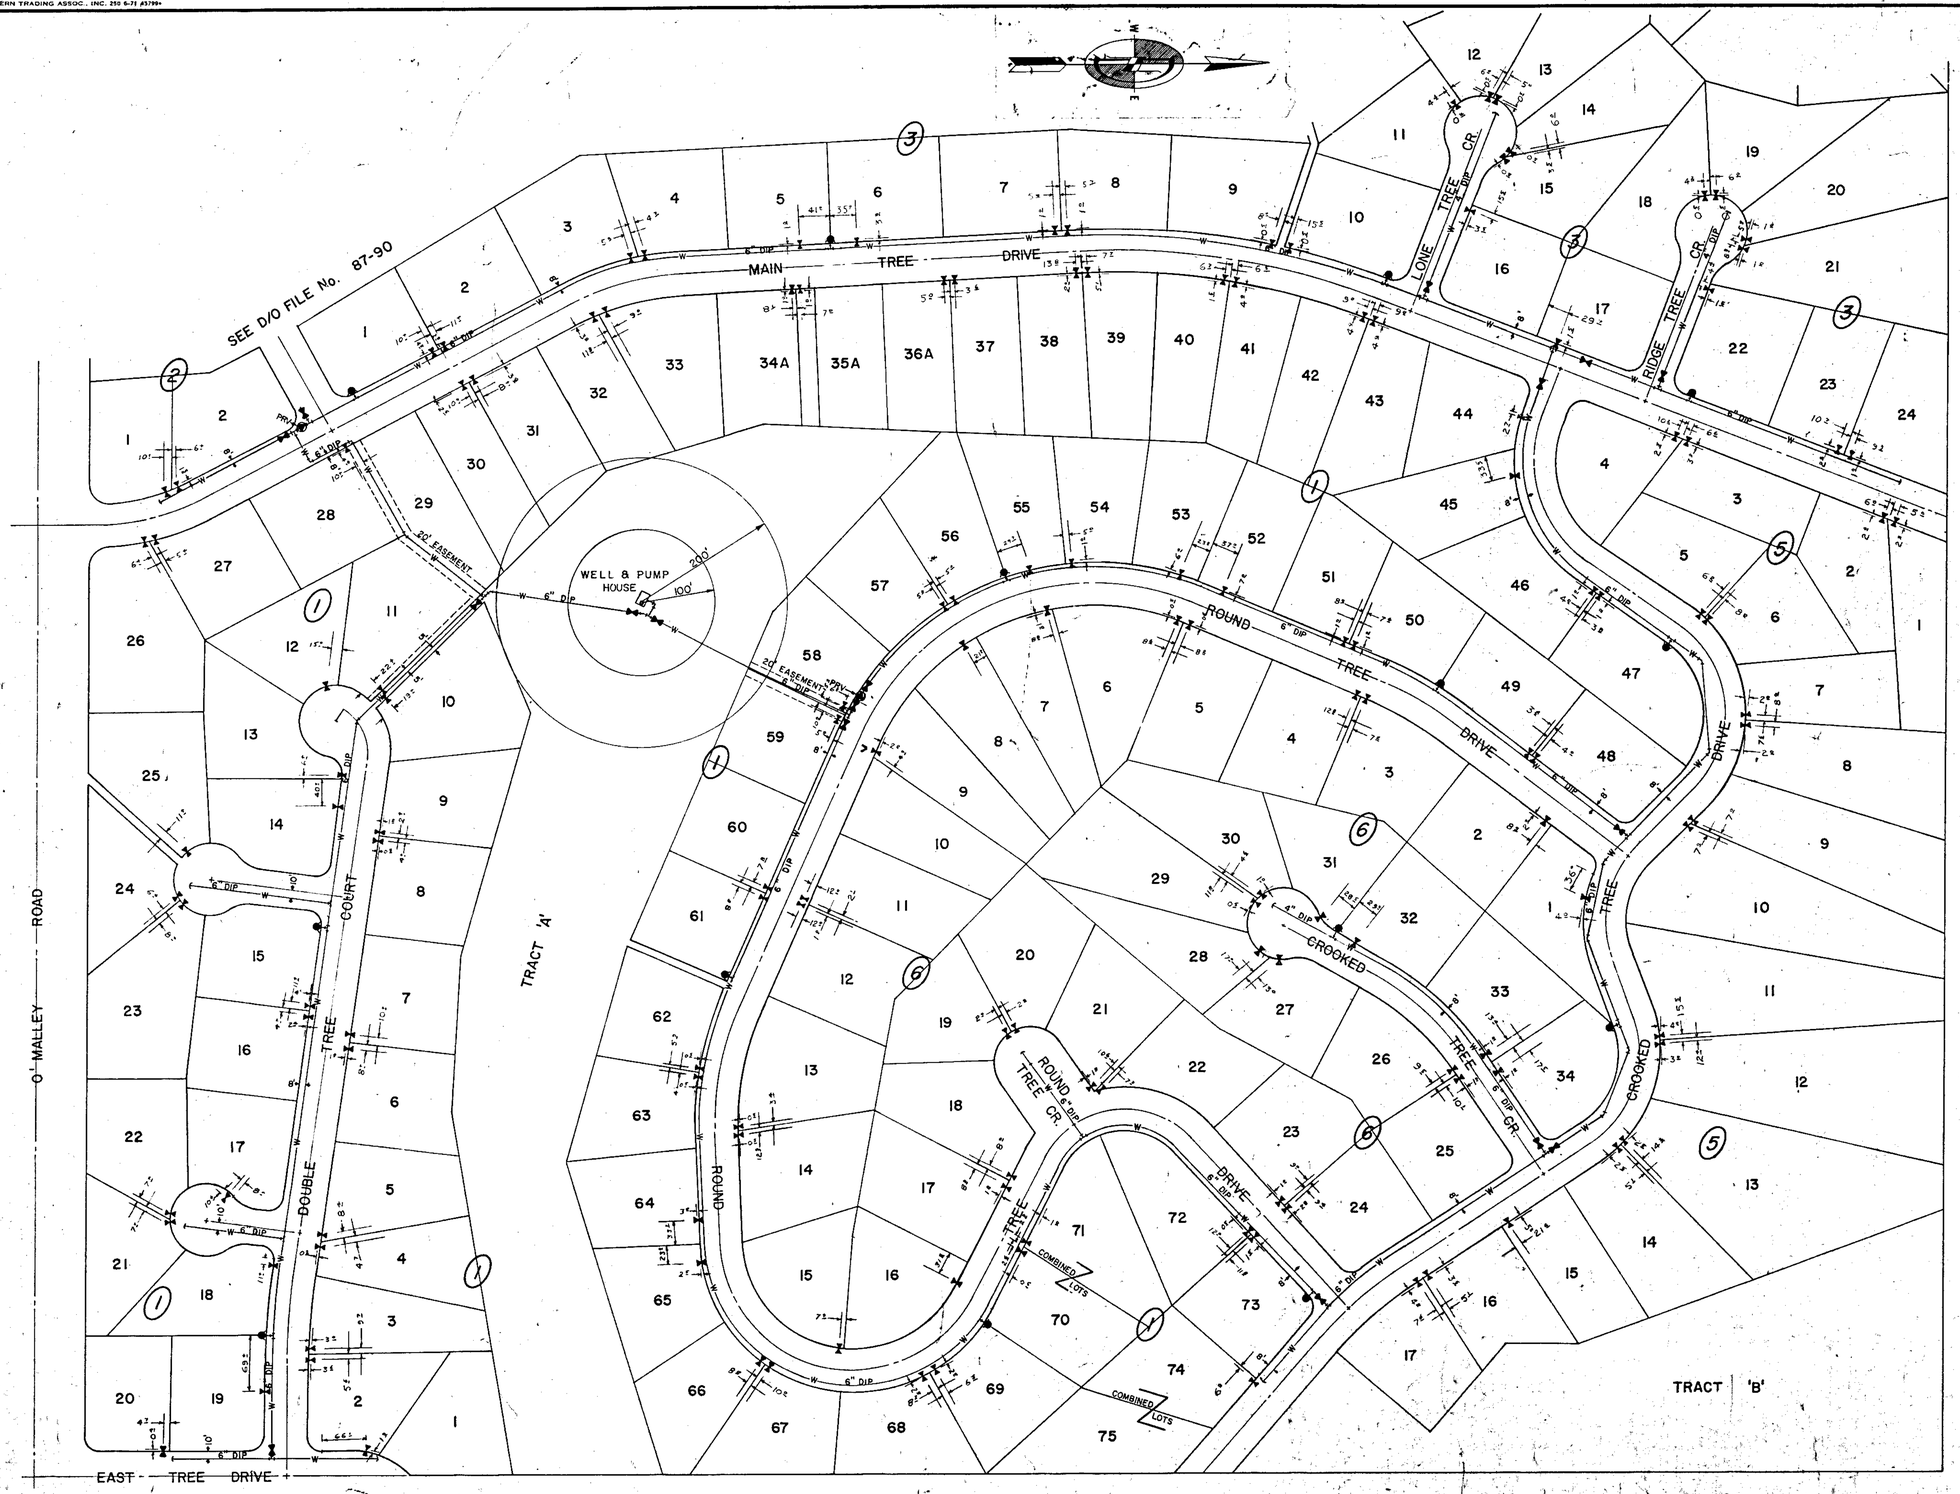

NOTES:

1. ASBUILT KEYBOX LOCATIONS NORTH OF WELL FROM FB 435-31, 17 SEPT. 1973.
2. ASBUILT KEYBOX LOCATIONS SOUTH OF WELL FROM FB 393-69, 13 NOV. 1972.

THIS PROJECT	EXISTING	LEGEND
—W—	—W—	WATERLINE
		HYDRANT
		VALVE & KEYBOX
		SERVICE CONNECTION
		PRESSURE REDUCING STATION
		TEMPORARY BENCH MARK
(W 32)		CURVE NO.

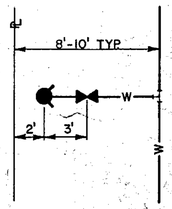

TYPICAL HYDRANT LOCATION
NO SCALE

DATE	BY	DATA	√ BY
DESIGNED	E.D.K.	San. Sewer	
		Storm Sewer	
DRAWN 9/14/73	E.Y.	Water	
		Gas	
CHECKED	E.D.K.	Telephone	
		Electric	
		Easements	
APPROVED		Footing Elev.	
		T.B.M. Date	

DATE	BY	REVISION
10-6-74	KH	ADDED- AS BUILT VALVE & KEYBOX
1-17-74	FA	ADDED- REVISED LEGEND
11/16/73	G.J.S.	ADDED AS-BUILT WATER SERVICE LOCATIONS FB 436

DICKINSON-OSWALD & PARTNERS
CONSULTING ENGINEERS
800 CORDOVA STREET
ANCHORAGE, ALASKA

VALLI-VUE ESTATES
WATER SYSTEM AS-BUILT

KEY MAP (EAST)

VALLI-VUE ESTATES

SCALE: Horz. 1 in. = 100' Vert.
F.B.
W.O. 6379
GRID 2538 2548

SHEET 2 OF 2

FILE NO. 92-72